City of San Jose - Building Division - Index Cover

Address 2415 S. King Rd-

PLAN CHECK NO. _____ **PERMIT NO.** 02059315

Prepared By _____ **Date** (Rev) 1-21-03

Category	Document Type	Sub Document Type
☐ MP Tracts	☐ TB Planning Permit	
	☐ PP Plot Plans	
	☐ TP Tract Plans	☐ PN Planning ☐ BD Building ☐ PB Plumbing ☐ MM Mechanical ☐ EE Electrical
	☐ TD Supporting Documents	
	☐ TC Structural Calculations	
	☐ TS Soils Report	
	☐ TT Trusses/Shop Drawings	
	☐ TM Tract Map	☐ AR Addressed
☒ PL Plans	☐ PI Planing Permit	
BEMP	☒ EP Plans	☐ PA Planning ☒ BL Building ☐ BP Plumbing ☐ BM Mechanical ☐ BE Electrical
	☐ PM Parcel Map	
	☐ SC Structural Calculations	
	☐ SD Supporting Documents	
	☐ SR Soils Report	
	☐ TR Trusses/Shop Drawing	
☐ PT Permits	☐ AD Addressing	
	☐ IN Inspection Notices	☐ EP Expired
	☐ PR Permits & Applications	☐ CC Cash Receipts / Refunds ☐ CO C of O ☐ CP Correspondence ☐ EX Expired / Voided ☐ FI Finals ☐ IN Initial ☐ MR Meter Releases ☐ SI Special Inspection Reports
	☐ CF Compliance Files	☐ CN Compliance Notices ☐ RS Rescind ☐ SW Stop Work Orders
	☐ DR Damage Reports	☐ ED Earthquake Damage ☐ FD Flood Damage ☐ FA Fire/Auto Survey

Rev. 7-3-00

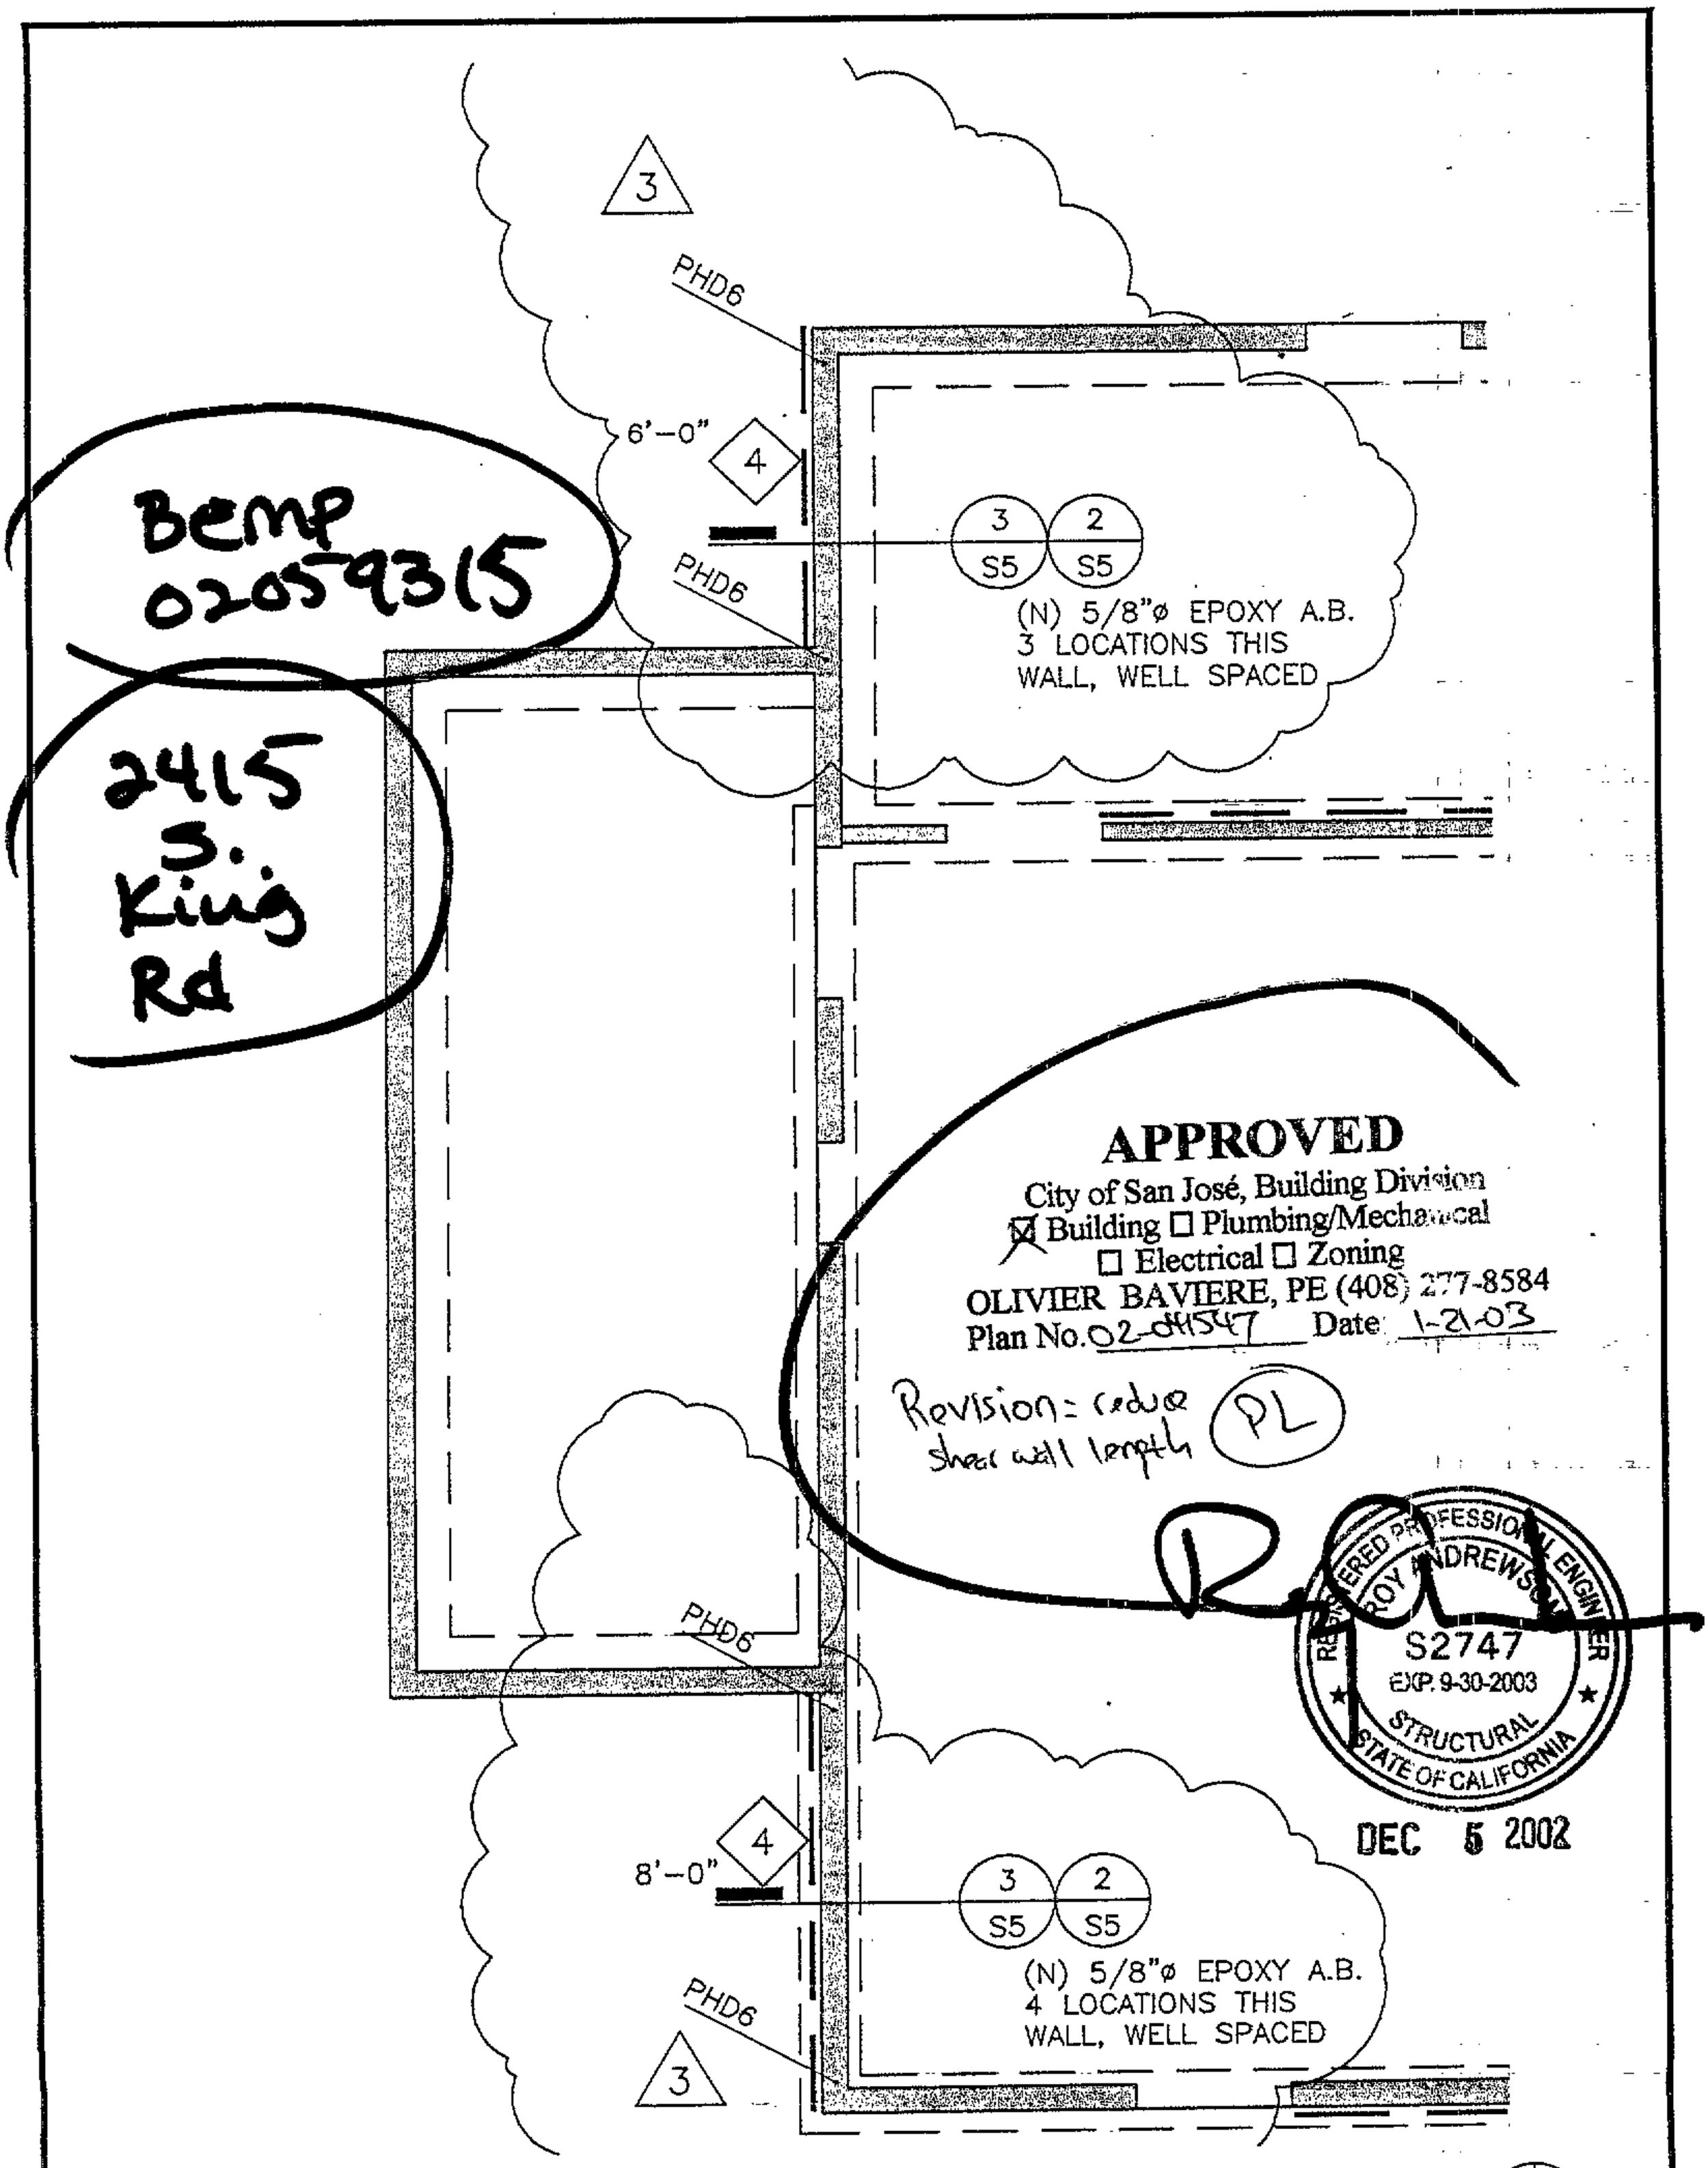

BEMP 02059315

2415 S. King Rd

APPROVED
City of San José, Building Division
☒ Building ☐ Plumbing/Mechanical
☐ Electrical ☐ Zoning
OLIVIER BAVIERE, PE (408) 277-8584
Plan No. 02-041547 Date: 1-21-03

Revision: reduce shear wall length (PL)

REGISTERED PROFESSIONAL ENGINEER ROY ANDREWSON S2747 EXP. 9-30-2003 STRUCTURAL STATE OF CALIFORNIA

DEC 5 2002

1 PARTIAL FOUNDATION PLAN

1/4"= 1'-0"

WEIR/ANDREWSON ASSOCIATES, INC
ENGINEERS & ARCHITECTS
990 A STREET, SUITE K
SAN RAFAEL, CA 94901
P 415.485.9797
F 415.485.9799

Exterior remodel to existing KFC/Taco Bell restourant
2145 South King Road, San Jose, CA 95122

JOB# 01084.03

REV.	DESCRIPTION	DATE	BY	DATE	PAGE
3	SHEAR WALL - FIELD CHANGES	12/03/02	VTT	05/30/02	S3-R
				CALC	
				✓ED VK	