60981

PLACE

60981

Sub Doc Type

BL

Number LG Docs

0011

Box Number

Street #

2011

Street Dir

Doc Type

PL

Street Name

NAGLEE

Street Type

AV

Tract Number

Document Date

7/10/86

	Prepped By	Scanned By	Indexed By	Verified By
Initials	RT	[illegible]		
Date	[illegible]	05/02/01		

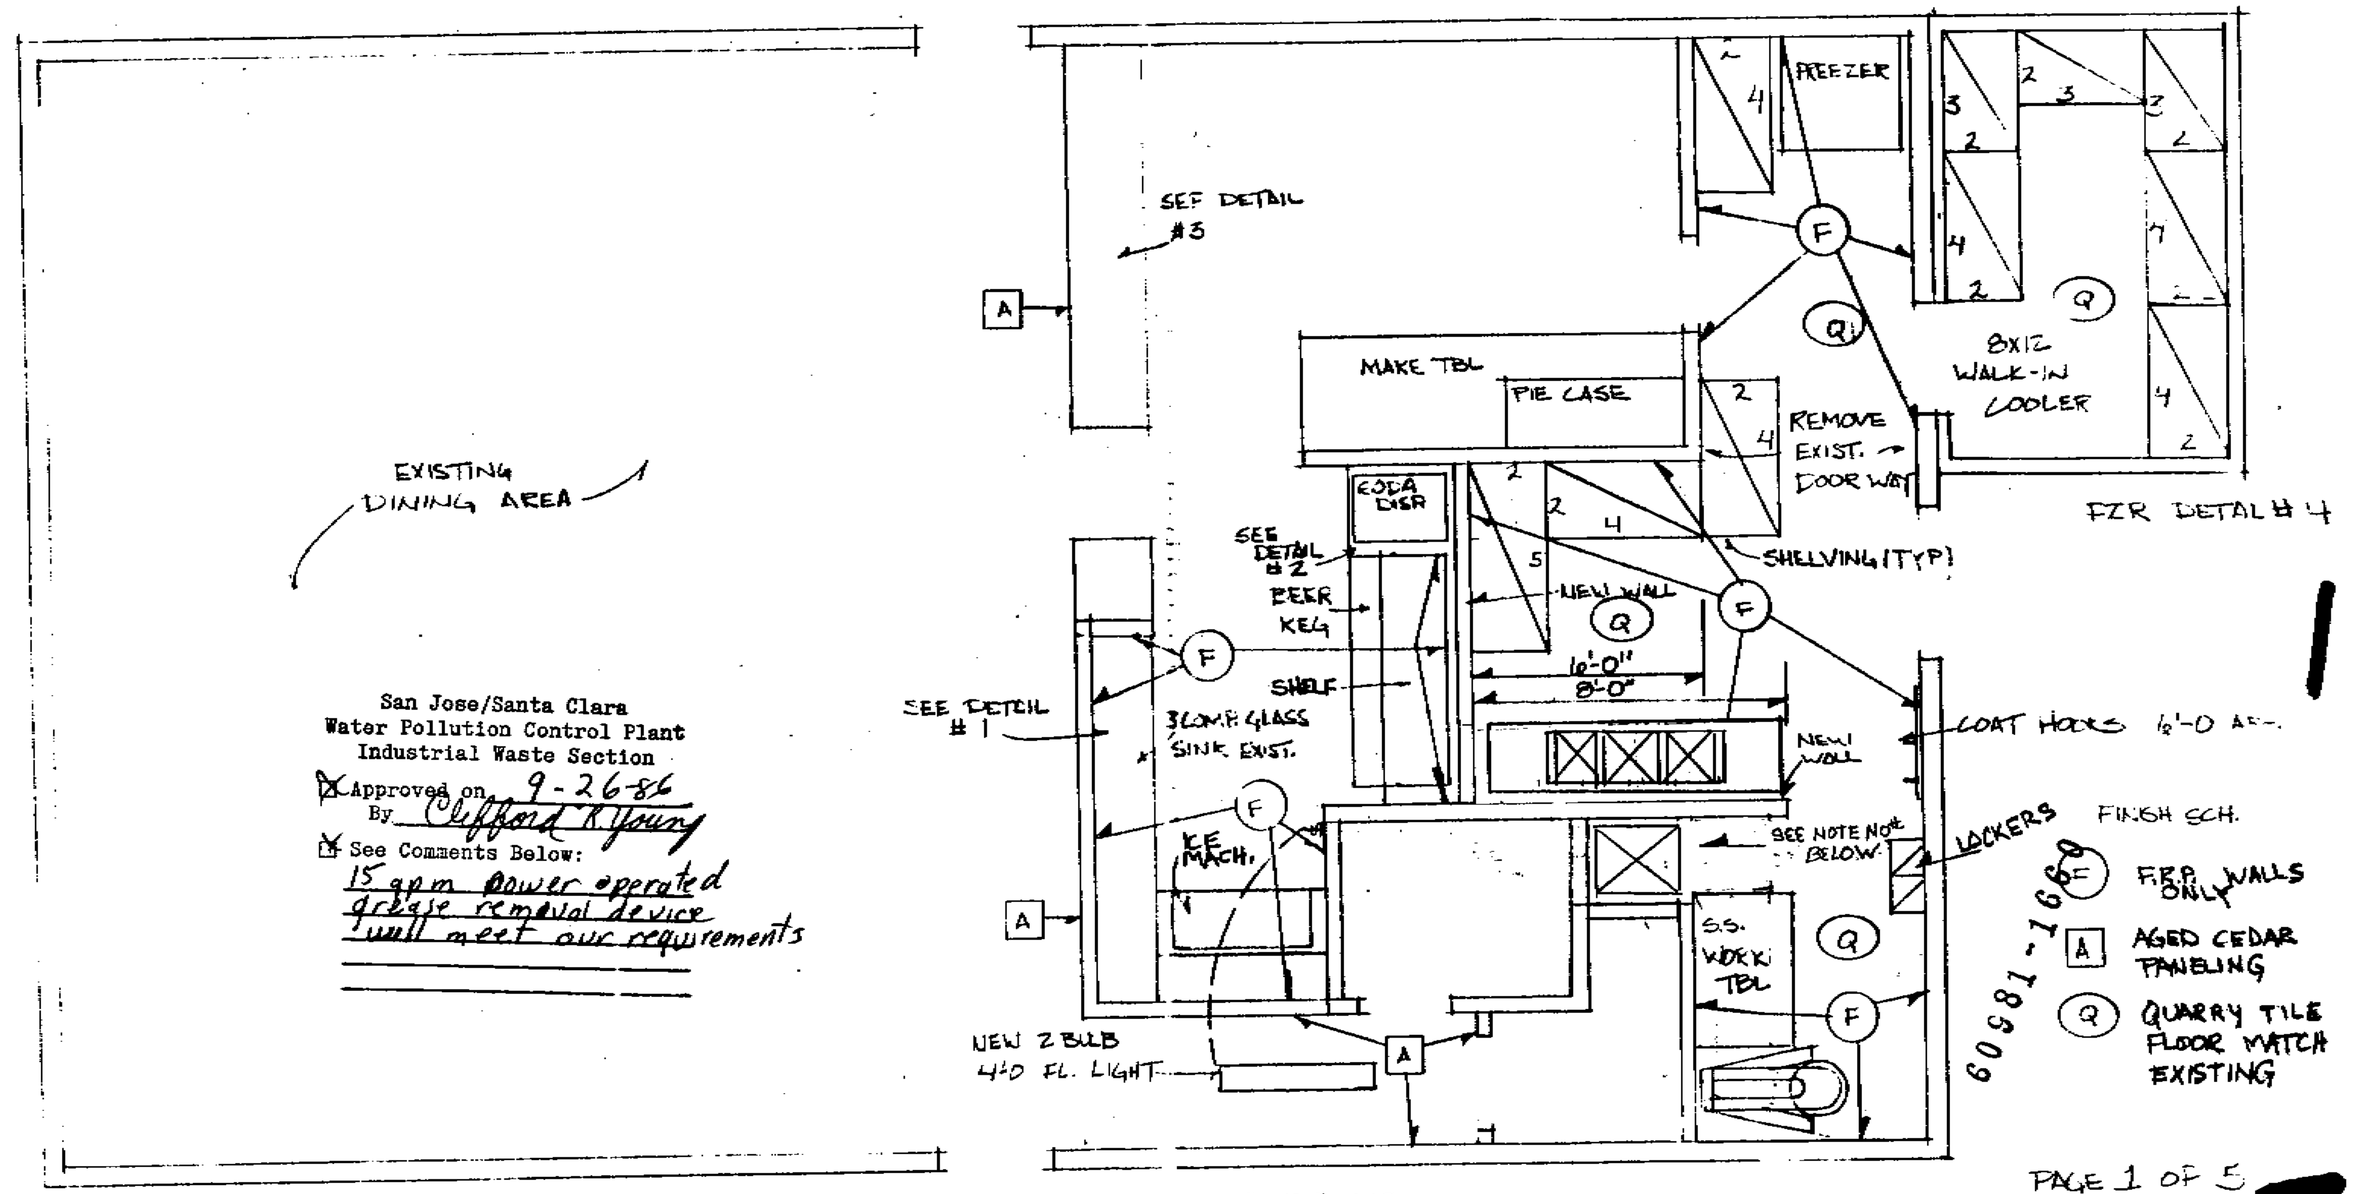

San Jose/Santa Clara
Water Pollution Control Plant
Industrial Waste Section

☒ Approved on 9-26-86
By Clifford R Young

☒ See Comments Below:
15 gpm power operated grease removal device will meet our requirements

60581-1669

1. NOTE: GENERAL CONTRACTOR SHALL INSTAL. 24"x 30" MIRROR TOWEL & SOAP DISP. SUPPLIED BY GENERAL CONTRACTOR

PAGE 1 OF 5

Pizza Hut

DRAWN:
DATE: 4/16/86
SCALE: 1/4"=1'-0"

LOCATION [redacted]
2011 NAGLEE AVE
SAN HOSE

Date 6-23-86 No. _____

APPROVED as submitted _____ as corrected ✓

SANTA CLARA COUNTY HEALTH DEPARTMENT
Environmental Health Services

By Tim Smith, R.S.
R.S. No. _____

EXISTING DINING AREA

NOTES:

1. LOCKERS - SUFFICIENT FOR ALL EMPLOYEES
2. FLOOR LEVEL 3'X3' MOP BASIN H & C FAUCET W/ BACK FLOW PREVENTER
3. HAND LAV - SOAP + TOWEL DISPENSER
4. INDIRECT WASTE TO FLOOR SINK IF FOOD PREP TAKES PLACE HERE

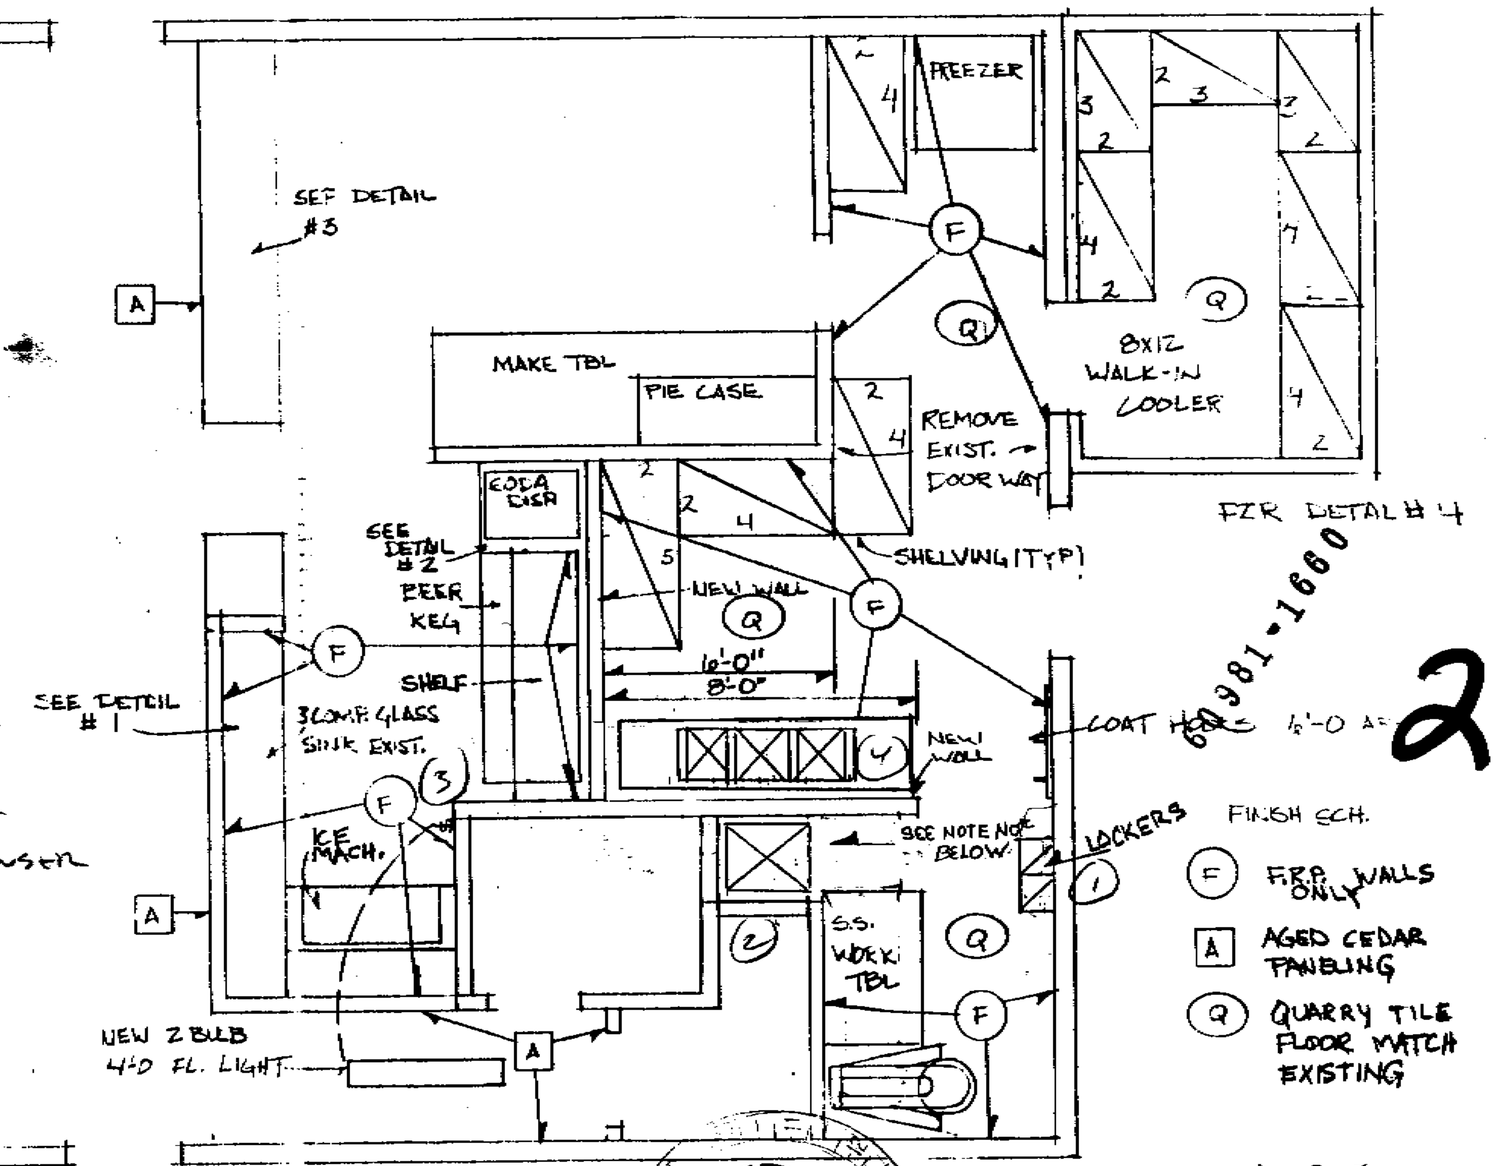

1. NOTE: GENERAL CONTRACTOR SHALL INSTAL. 24"X 30" MIRROR TOWEL & SOAP DISP. SUPPLIED BY GENERAL CONTRACTOR

RECEIVED JUN 23 1986 ENVIRONMENTAL HEALTH SERVICES

PAGE 1 OF 5

Pizza Hut	DRAWN:	LOCA[redacted]
	DATE: 4/16/86	2011 M[redacted] AVE
	SCALE: 1/4"=1'-0"	SAN HOSE

69981-1660

2

2X4 STUD WALL W/ ½ GYP. W/ ⅛ FRP ON WAITRESS SIDE & AGED CEDAR ON DINING SIDE

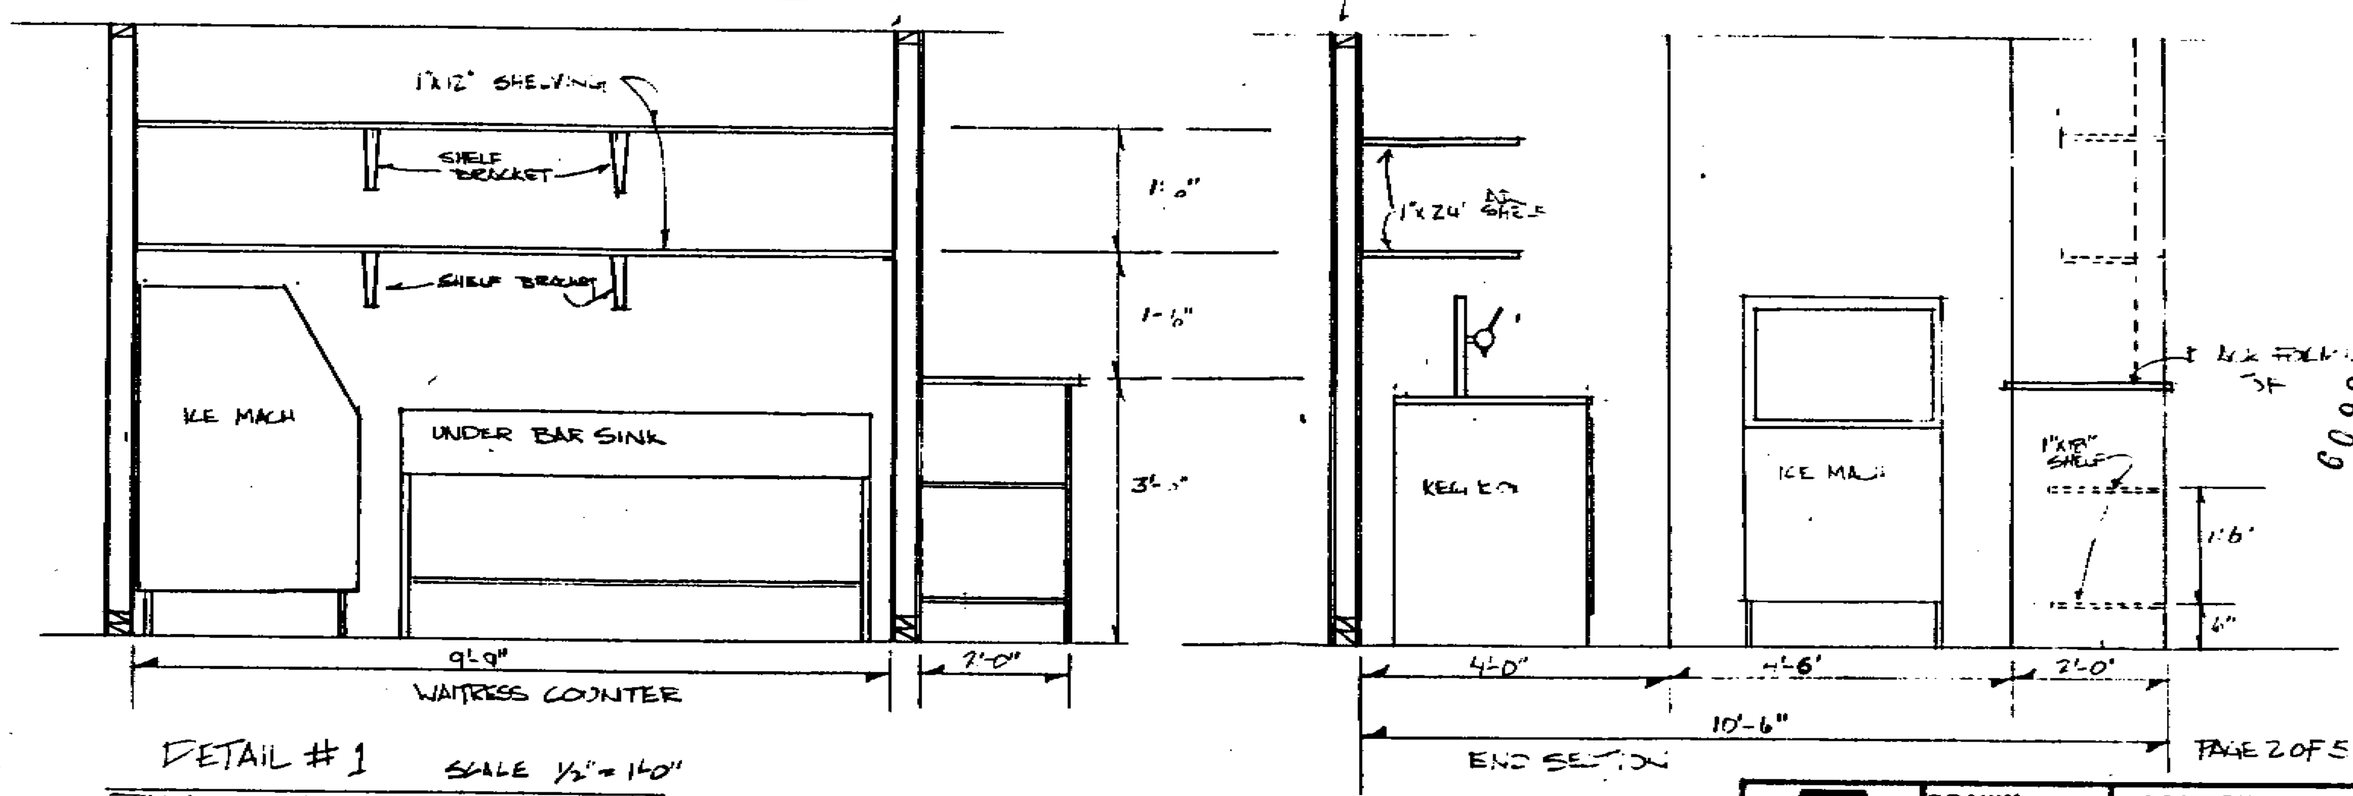

DETAIL #1 SCALE ½" = 1'-0"

PAGE 2 OF 5

Pizza Hut

DRAWN:

DATE: 4/16/86

SCALE:

LOCATION: 10300

2011 NAGLEE AVE

SAN JOSE, CA

[redacted]

6098-1660

3

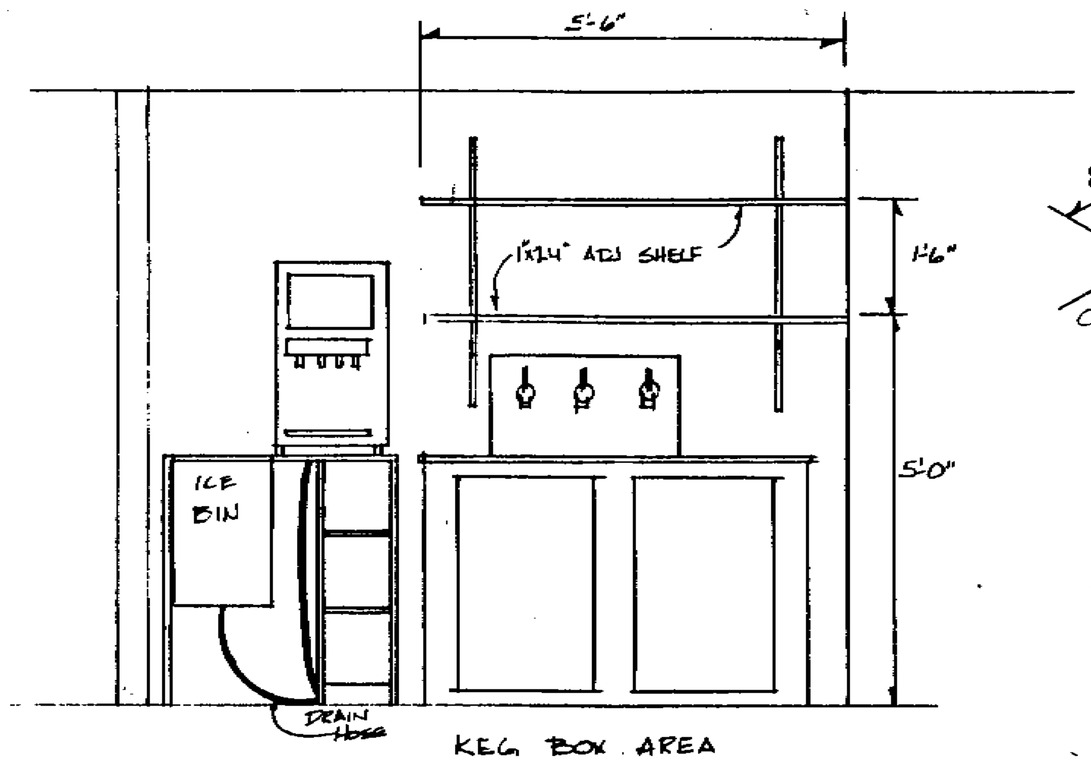

KEG BOX AREA

DETAIL #2 SCALE ½"=1'-0"

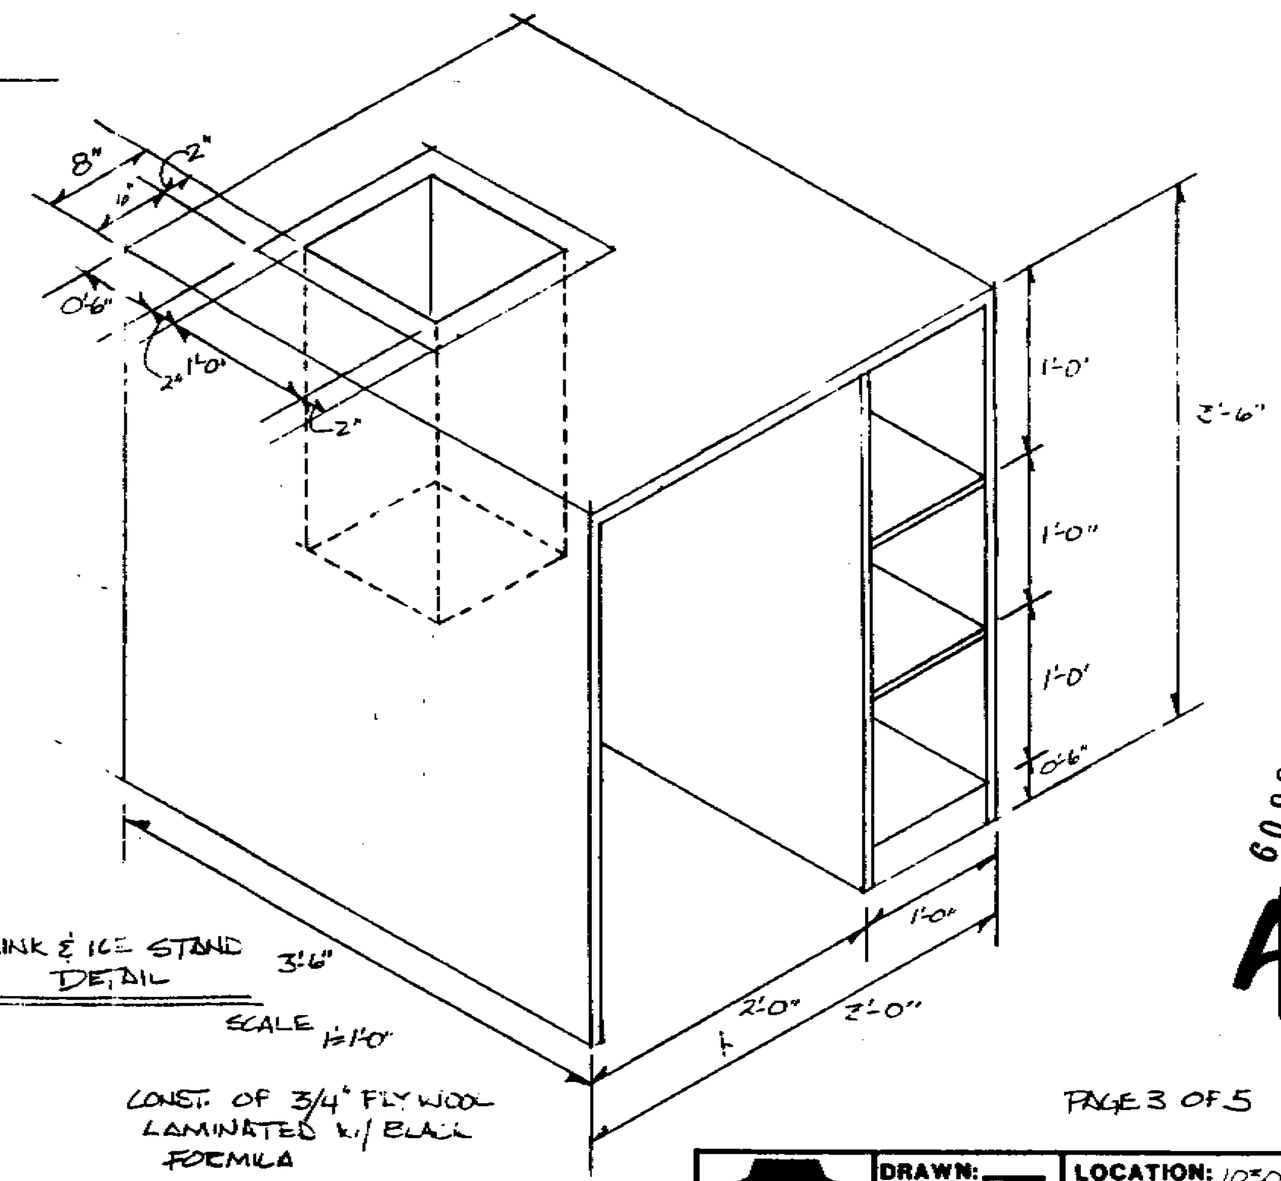

DRINK & ICE STAND DETAIL

SCALE 1"=1'-0"

CONST. OF 3/4" PLYWOOD LAMINATED W/ BLACK FORMICA

60981-1660

4

PAGE 3 OF 5

Pizza Hut	DRAWN:	LOCATION: 103005
	DATE: 4/16/96	2011 NAGLEE RD
	SCALE:	SAN JOSE, CA

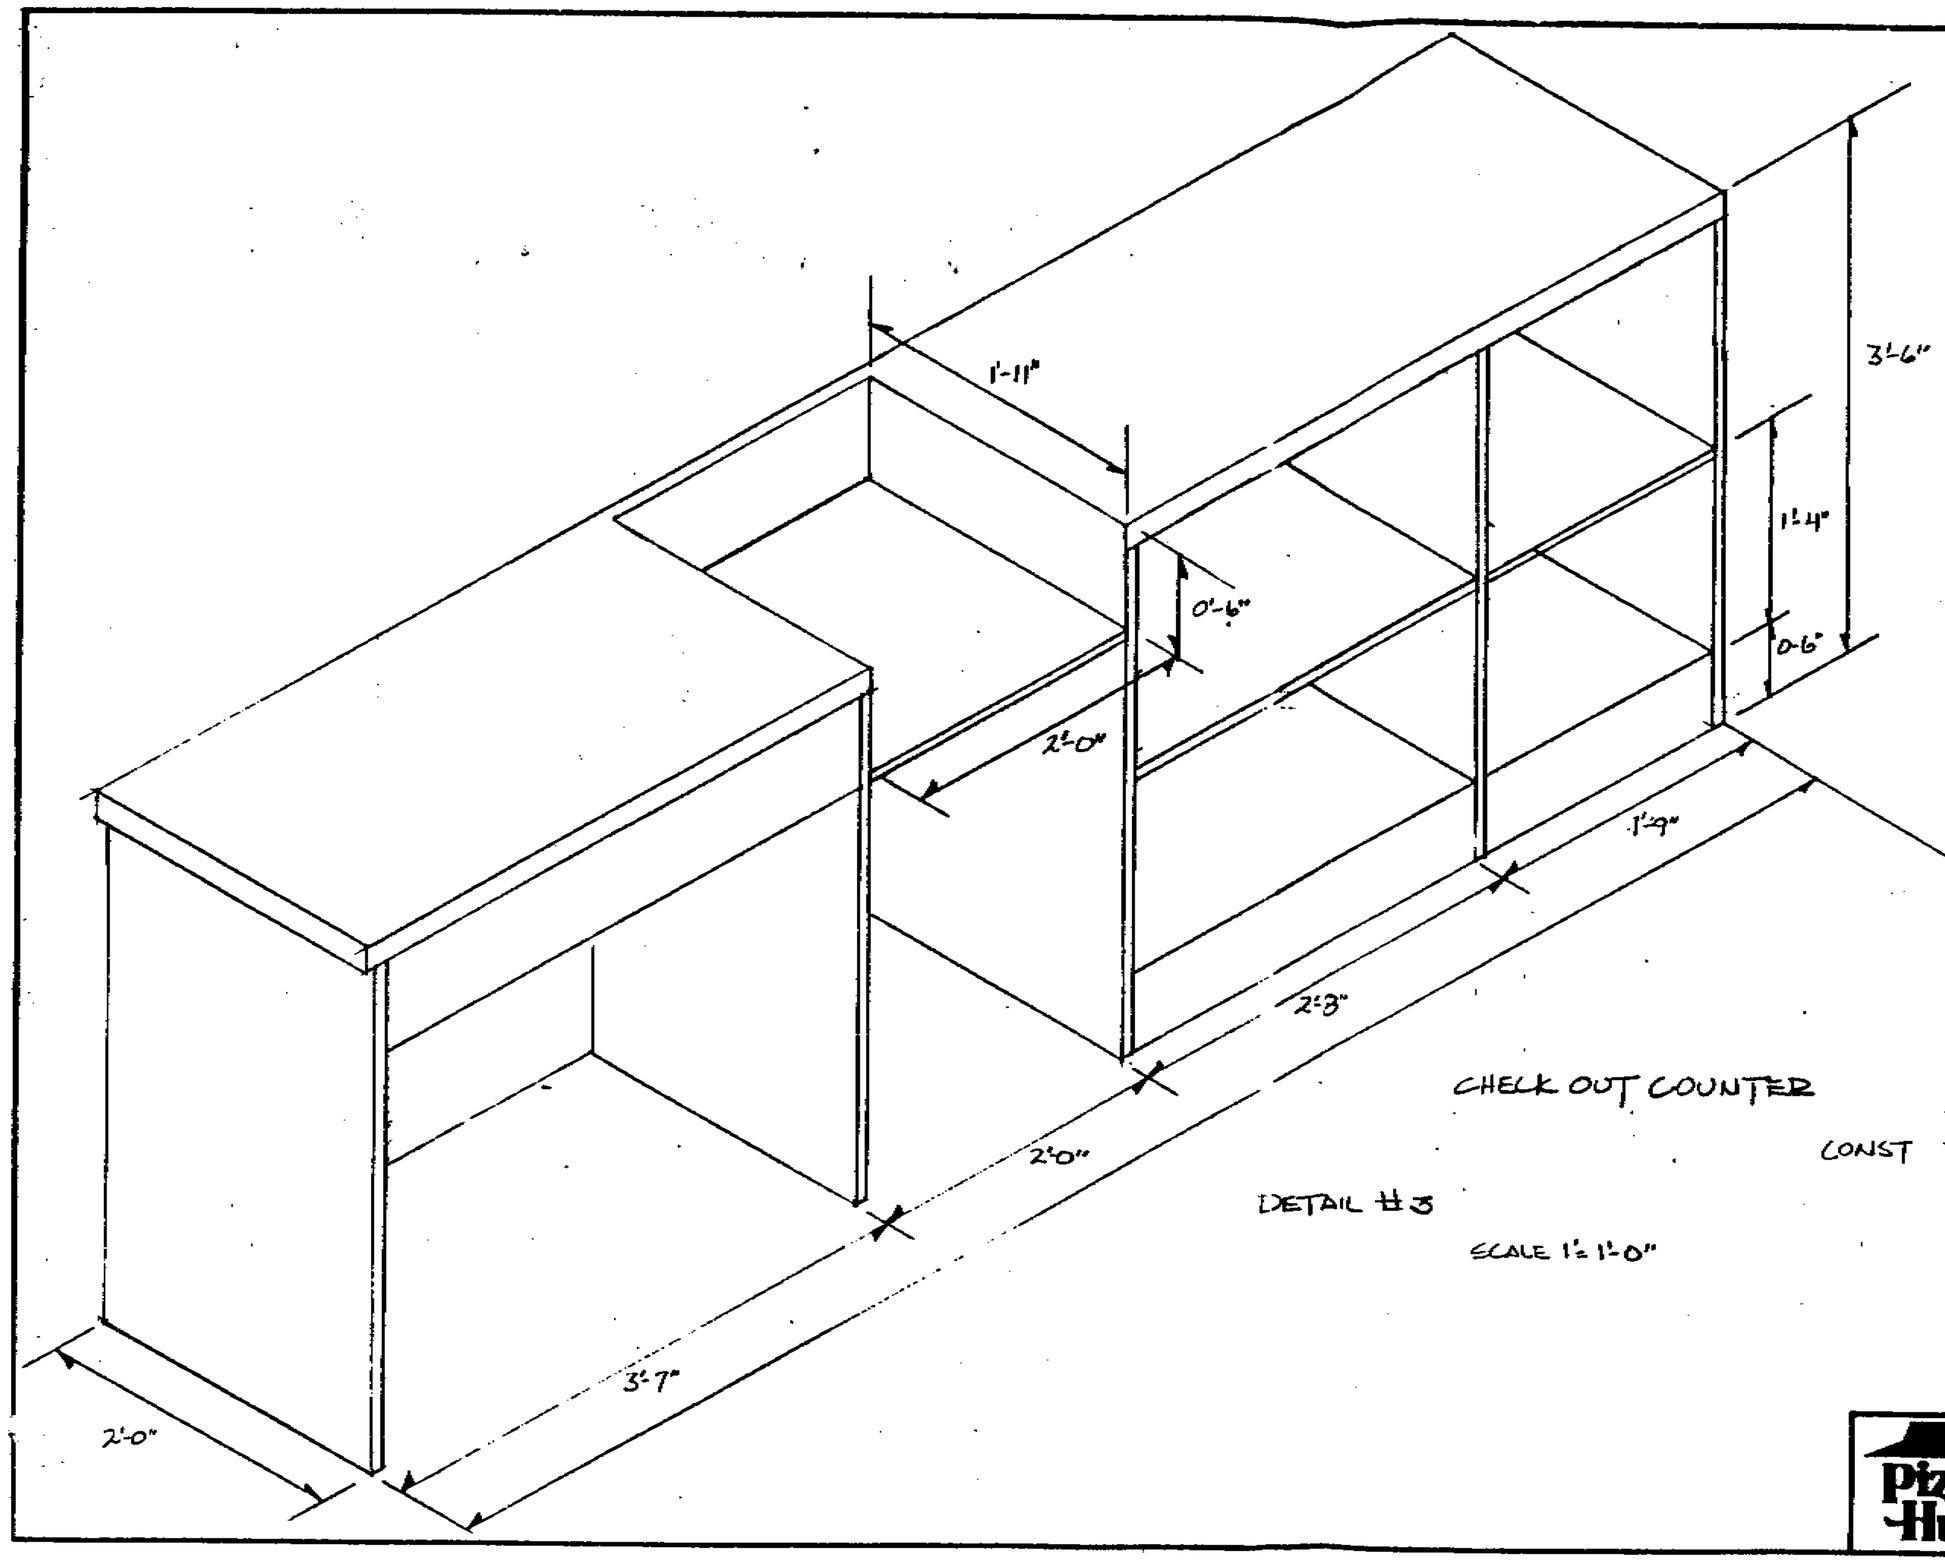

CHECK OUT COUNTER

DETAIL #3

SCALE 1" = 1'-0"

CONST 3/4" PLYWOOD
OUTSIDE FINISH AGER CEDAR
WHITE ENAMEL INSIDE
TOP BLACK FORMICA.

60981-1660

5

PAGE 4 OF [redacted]

Pizza Hut	DRAWN:	LOCATION: 103005
	DATE: 4/16/85	2011 NAGLEE AVE
	SCALE:	SAN JOSE, CA

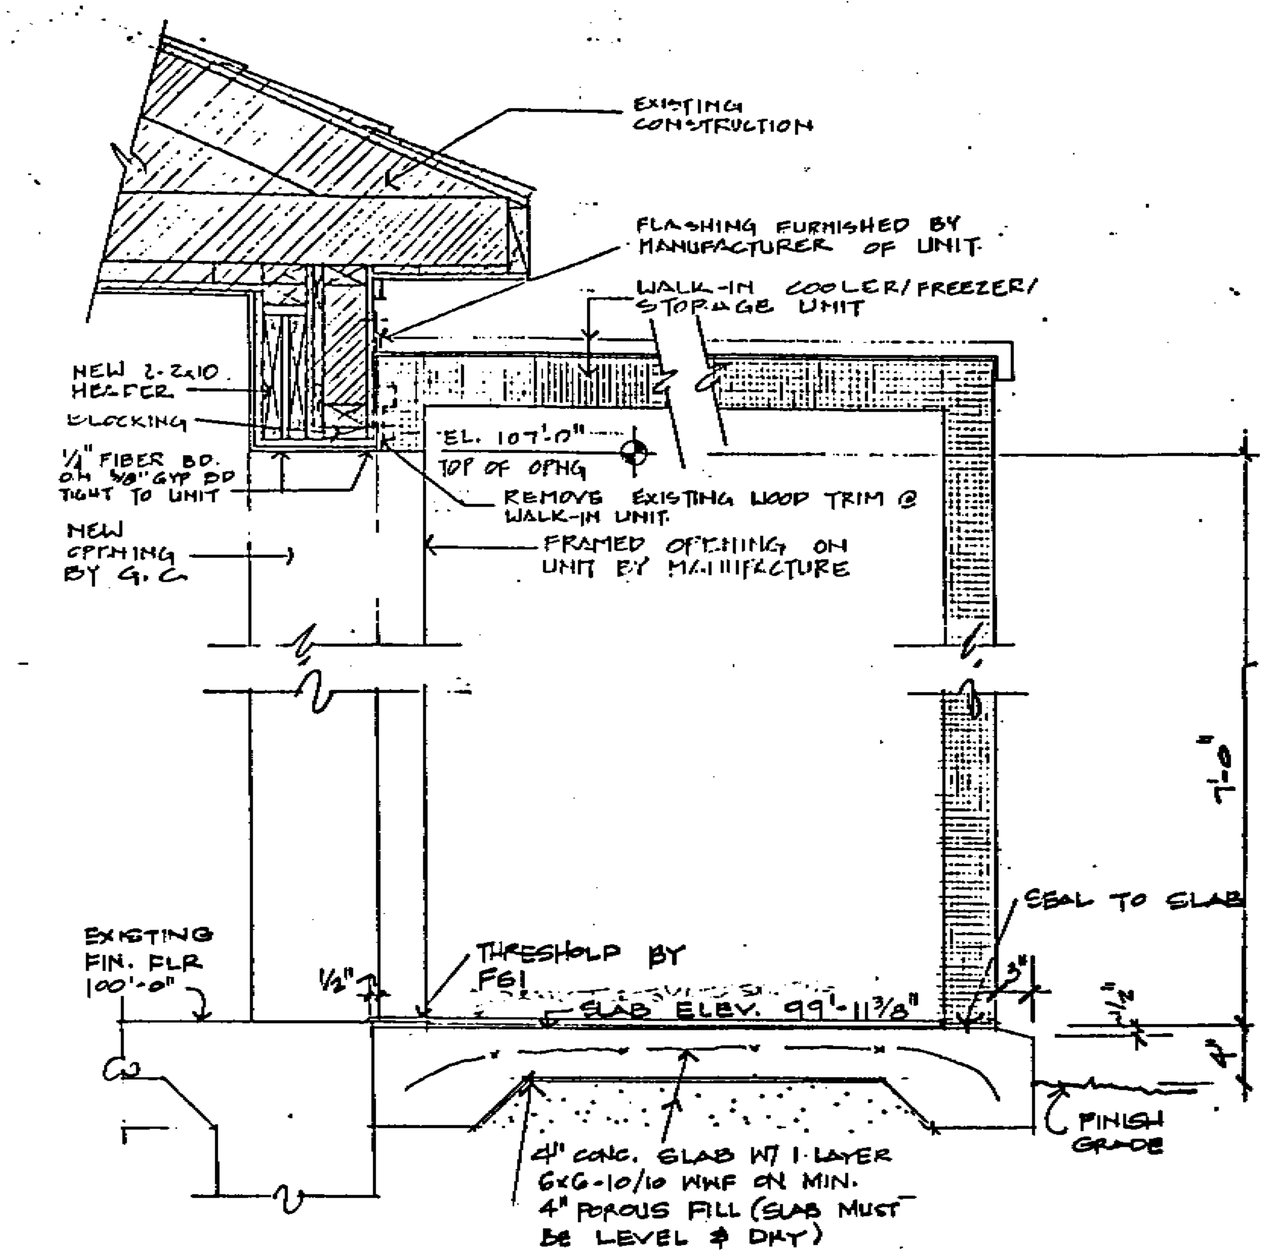

SECTION THRU PREFAB. WALK-IN UNIT
1" = 1'-0"

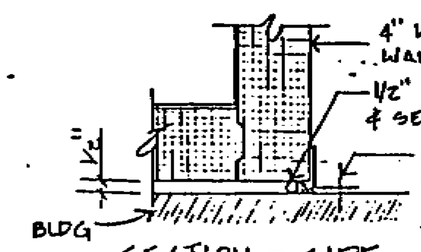

SECTION @ SIDE
1 1/2" = 1'-0"

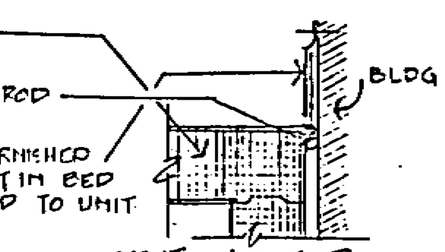

SECTION @ TOP
1 1/2" = 1'-0"

DETAIL #4

60981-1660

6

PAGE 5 OF [redacted]

Pizza Hut

DRAWN: ____
DATE: 4/16/85
SCALE: —

LOCATION: [illegible]
2011 NAGLEE AV
SAN JOSE, CA

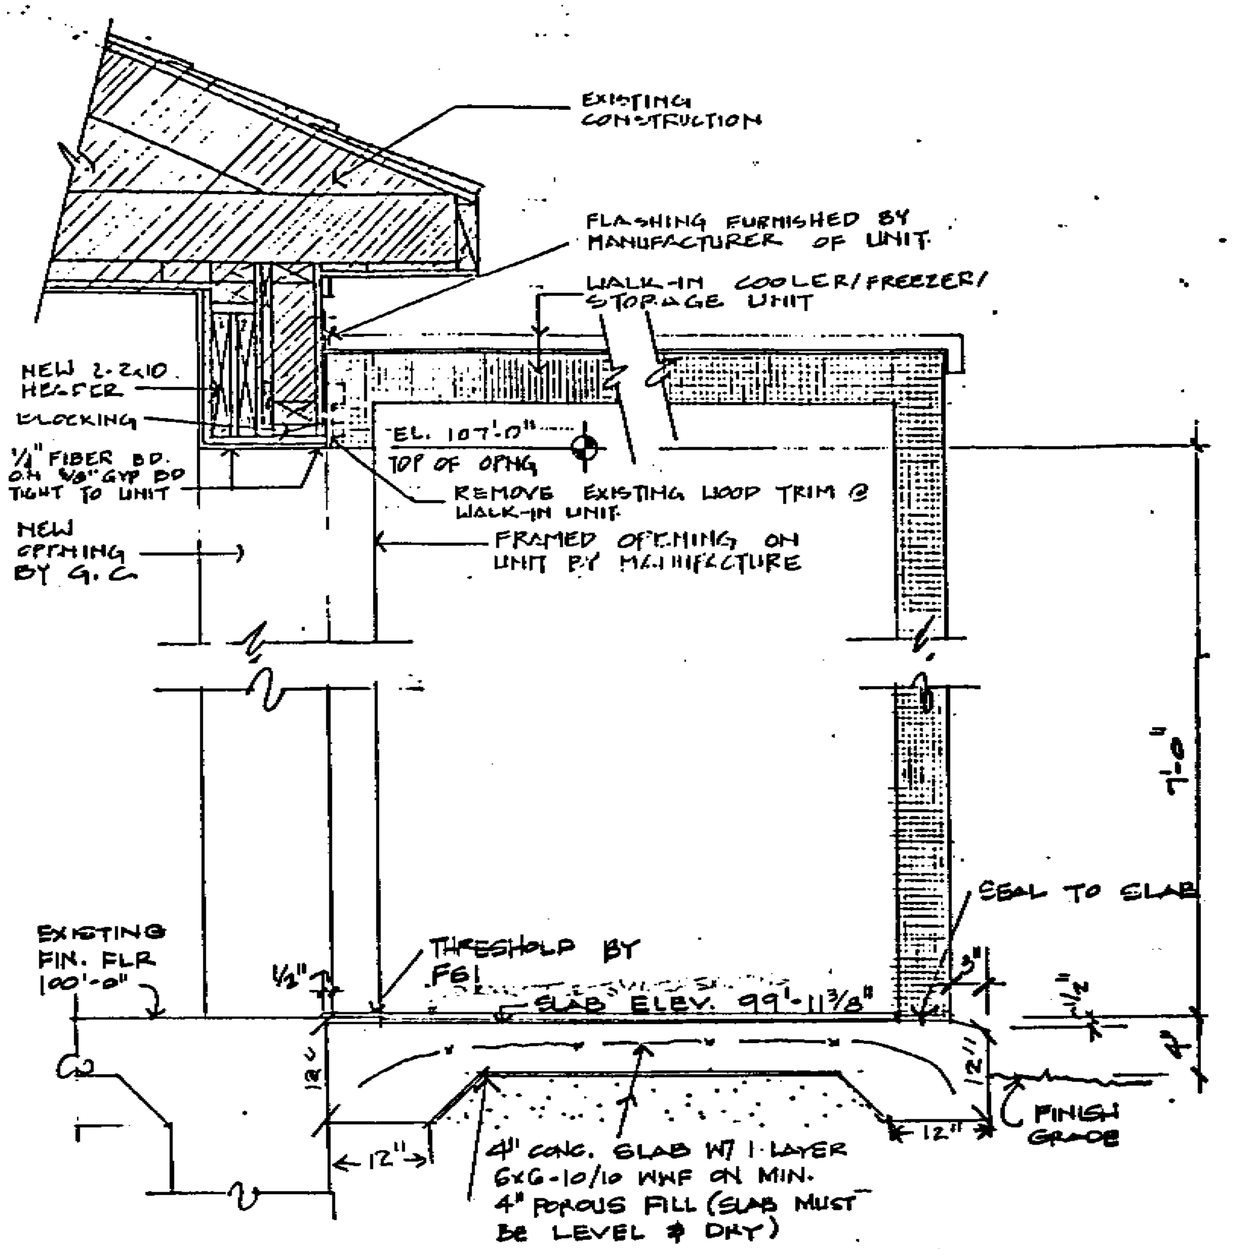

SECTION THRU PREFAB. WALK-IN UNIT
1" = 1'-0"

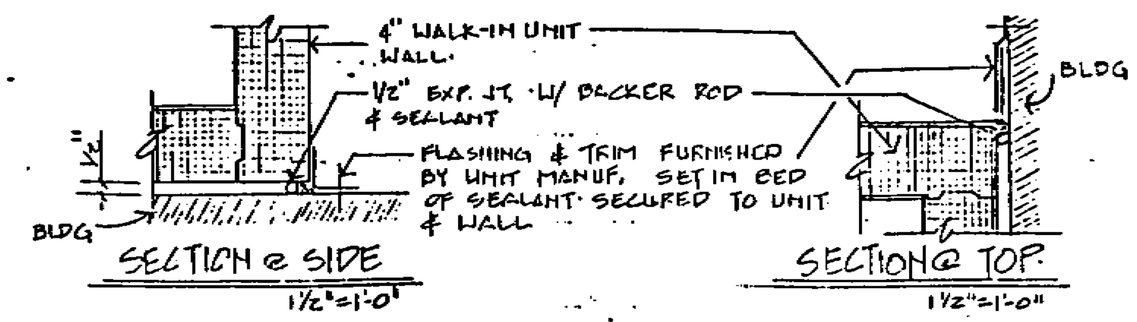

SECTION @ SIDE
1 1/2" = 1'-0"

SECTION @ TOP
1 1/2" = 1'-0"

NOTE: 12"x12" FOOTERS ADDED UNDER COOLER

60981-1660

7

DETAIL #4

PAGE 5 OF 5

Pizza Hut	DRAWN:	LOCATION: 103 [illegible]
	DATE: 6/18/86	2011 NAGLEE AV
	SCALE: —	SAN JOSE, CA

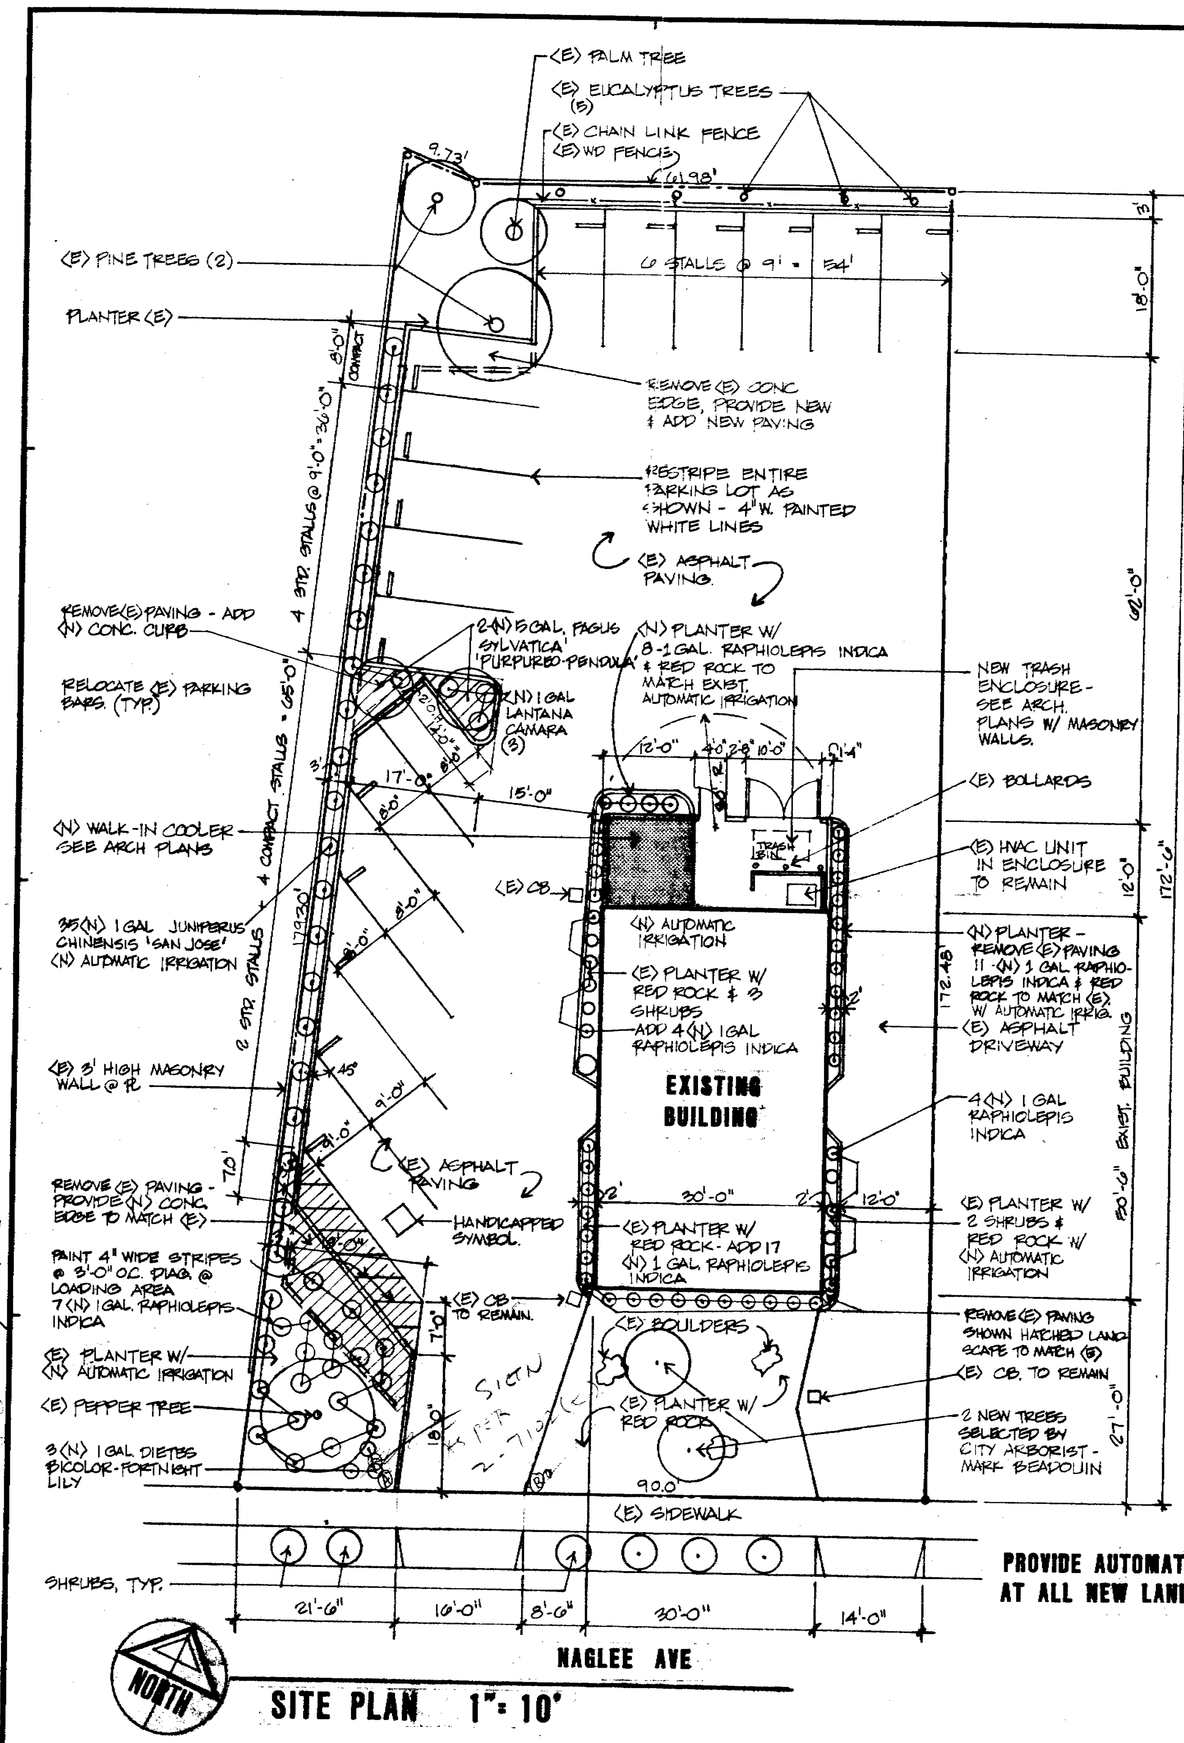

PROVIDE AUTOMATIC CONTROLLED IRRIGATION AT ALL NEW LANDSCAPED AREAS

1. PLAN'G DEPT APP'L (RM 400) appl # 1185-11-249
2. PUBLIC WORKS DEP'T CLEARANCE (RM 40).
3. FIRE DEP'T REPORT
4. HEALTH DEPT APP'L → SEE PLAN
5. WATER POLLUTION CONTROL → Grease Trap requirements 279-6060
6. PROVIDE ~~[illegible]~~ TOILET FACILITIES PER UBC 705
7. VENEER SUPPORT AS PER UBC 70

RETURN THIS SET W/ 2 REVISE SETS

V = 22 K

B/P = 152.50
SMIPA = 1.54
B&S = 330.00
C = 660.00
1144.04
CONST TAX = 7.65 = .08 × 96 d
1151.72

00001-1000

Val.	22,000
75	114 38
20	30 50
P/C	144 88

Told applicant about Planning Approval

8

BP 60941 PC 18-228-8

PC 35344

JOB NO.	8610
DRAWN:	KJV
CHECKED:	
DATE:	4·14·86

REVISIONS

MK.		DATE
A	REVISIONS PARKING	5/13/86
B	LANDSCAPE	5/27/86
C	CITY NOTIFICATION	6/11/86

COPYRIGHT © 1986 MARVIN BAMBURG ASSOCIATES

MARVIN BAMBURG ASSOCIATES
1017 MERIDIAN AVE
SAN JOSE, CA 95125
(408) 267-2780
ARCHITECTS AIA

M.A.BAMBURG C-4649

ALL DRAWINGS AND WRITTEN MATERIAL APPEARING HEREIN CONSTITUTE THE ORIGINAL AND UNPUBLISHED WORK OF THE ARCHITECT AND MAY NOT BE COPIED OR USED WITHOUT THE WRITTEN CONSENT OF THE ARCHITECT.

SHEET TITLE: SITE PLAN 1" 10'

PIZZA HUT
2011 NAGLEE AVENUE
SAN JOSE, CA

SHEET NO. G1 OF

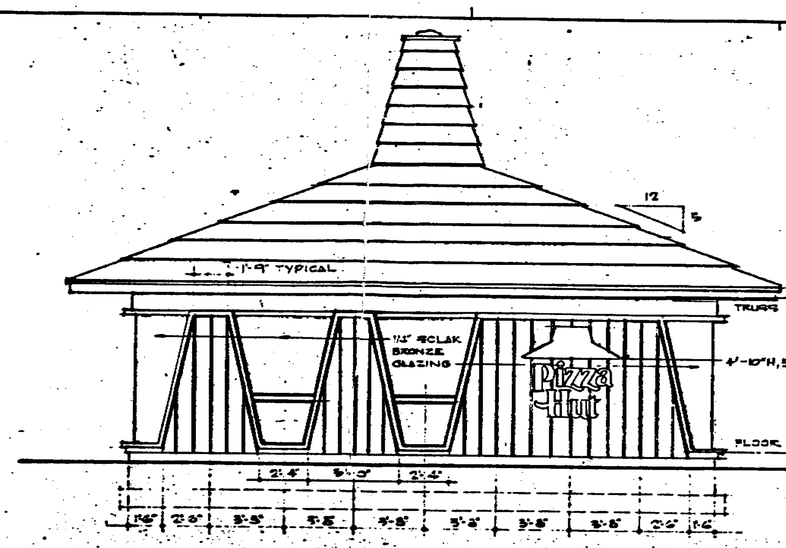

FRONT ELEVATION
1/4" = 1'-0"

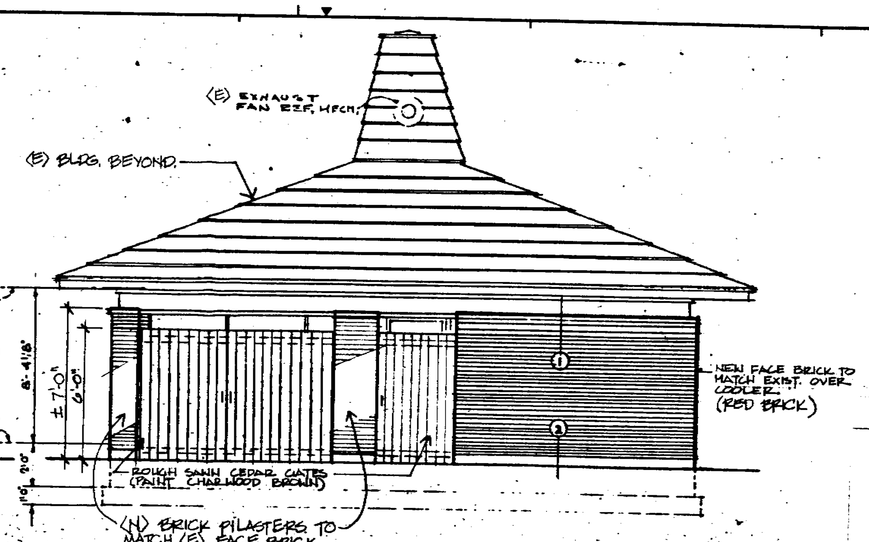

REAR ELEVATION
1/4" = 1'-0"

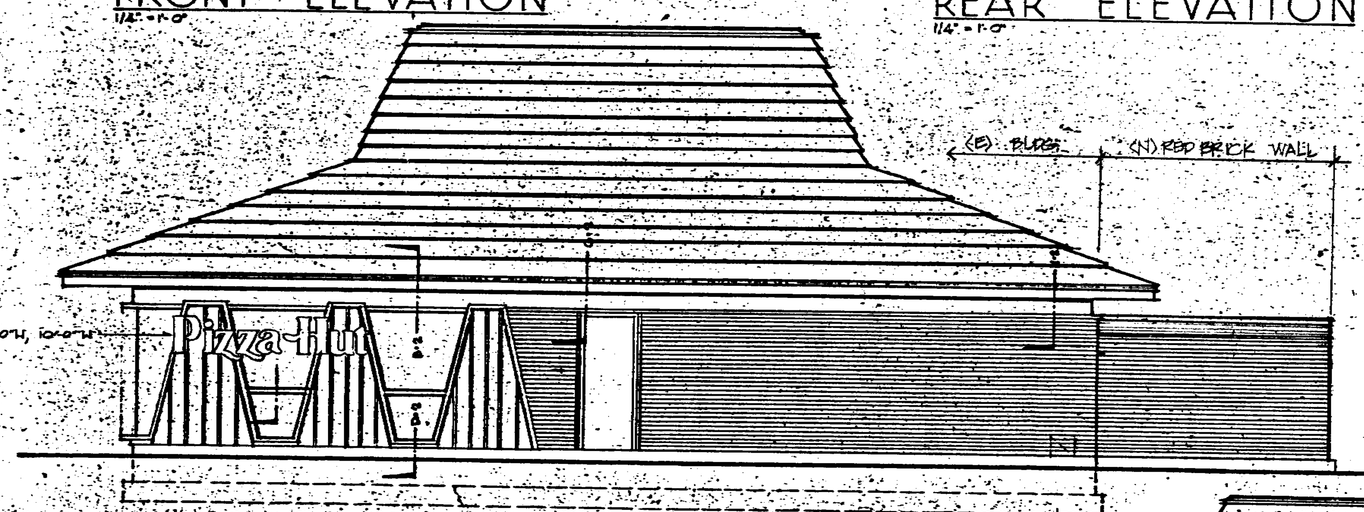

RIGHT ELEVATION
1/4" = 1'-0"

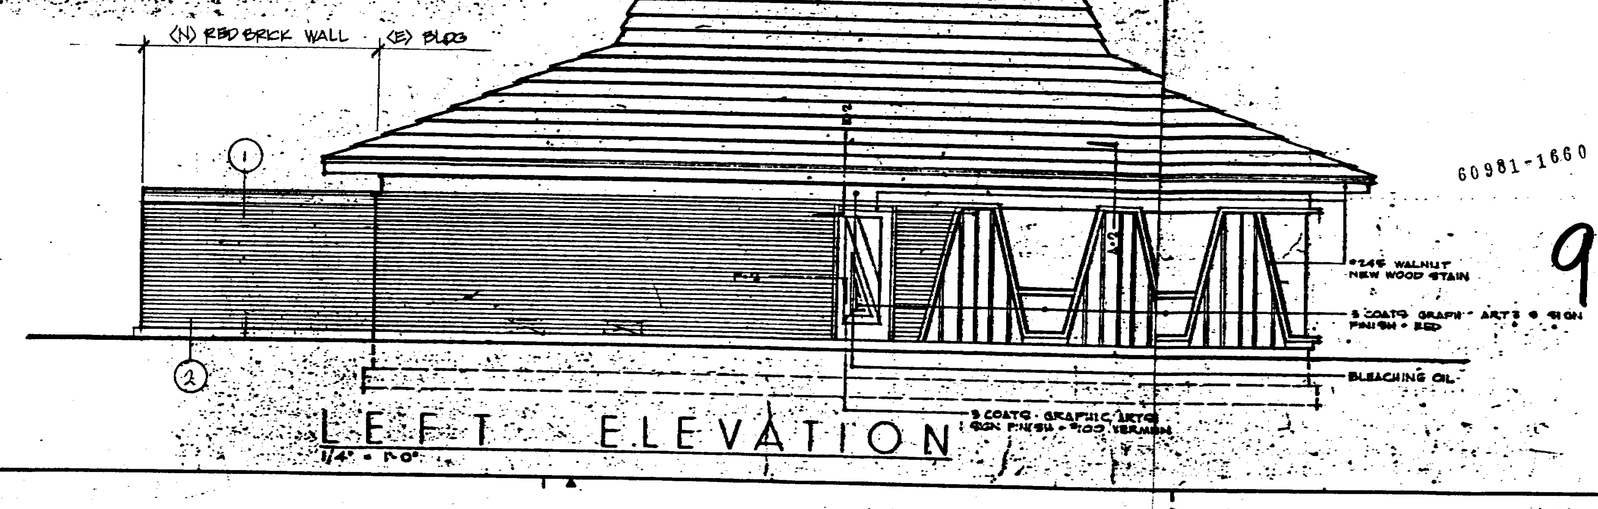

LEFT ELEVATION
1/4" = 1'-0"

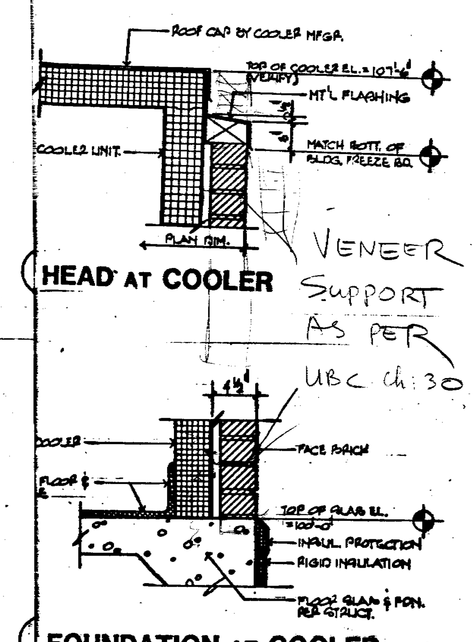

HEAD AT COOLER

FOUNDATION AT COOLER

60981-1660

9

Pizza Hut

PIZZA HUT, INC.

9111 EAST DOUGLAS
POST OFFICE BOX 428
WICHITA, KANSAS 67201

The design and details disclosed herein are the exclusive property of Pizza Hut, Inc., and shall not be copied or reproduced in whole or in part without its prior written consent.
©1985 PIZZA HUT, INC.
9111 E. DOUGLAS,
BOX 428
WICHITA, KANSAS 67201

NAGLEE AVENUE #103005
SAN JOSE, CALIFORNIA

DATE	BY	CHK'D
4-16-86	MLN	cp.
REVIS'D	BY	CHK'D
6-1-86		

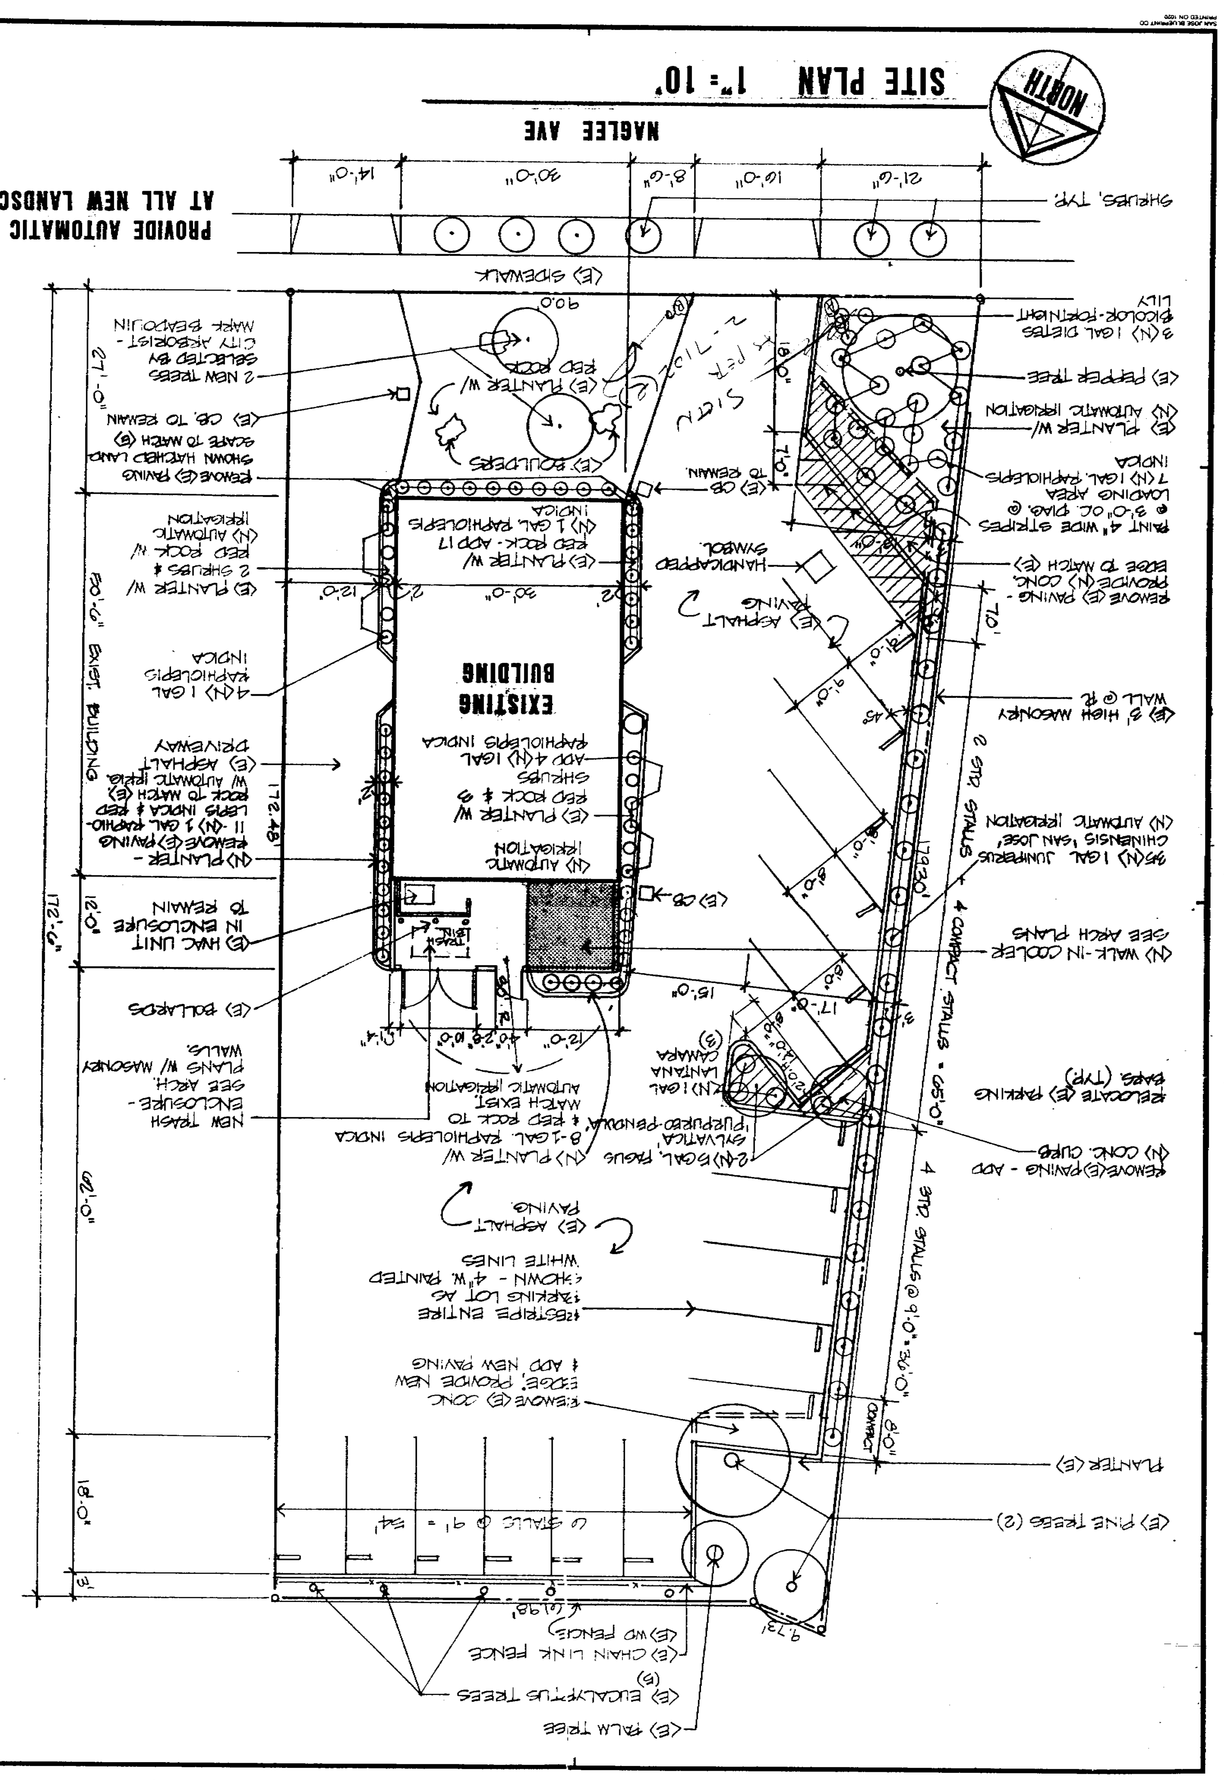

1. Planning Dept Appl. (RM 400) approved
2. Public Works Dept - Landscape (RM 300)
3. Fire Dept report
4. Hazardous Dept All → SEE PLAN
5. Public Education Control → Green Trap requirements 279-6060
6. Provide ~~[illegible]~~ Toilet facilities as per UBC 705

Return This Set w/ 2 Revise Sets

H85-112495 (Duplicate)
FINAL CHECKOUT
PLANNING DEPARTMENT
10/23/96
Sht. G-1, G-2 only

Vol. 22,000
75 11 4 [illegible]
20 30 50
EPC 144 88

Total applicant fees and approved plans

H85-112495

10

SHEET NO. G1 OF

SHEET TITLE: SITE PLAN 1" 10'

PIZZA HUT
2011 NAGLEE AVENUE
SAN JOSE, CA

COPYRIGHT © 1996
MARVIN BAMBURG ASSOCIATES

MARVIN BAMBURG ASSOCIATES
1017 MERIDIAN AVE
SAN JOSE, CA 95125
(408) 267-2780

AIA ARCHITECTS

M.A.BAMBURG C-4649

ALL DRAWINGS AND WRITTEN MATERIAL APPEARING HEREIN CONSTITUTE THE ORIGINAL AND UNPUBLISHED WORK OF THE ARCHITECT AND MAY NOT BE DUPLICATED, USED OR DISCLOSED WITHOUT THE WRITTEN CONSENT OF THE ARCHITECT

REVISIONS

MK.	DATE	
1		REVISIONS PLANNING
2		INTERCOMS
3		CITY MODIFICATION
4		
5		

JOB NO. 8610
DRAWN: GJV
CHECKED:
DATE: 4-14-86

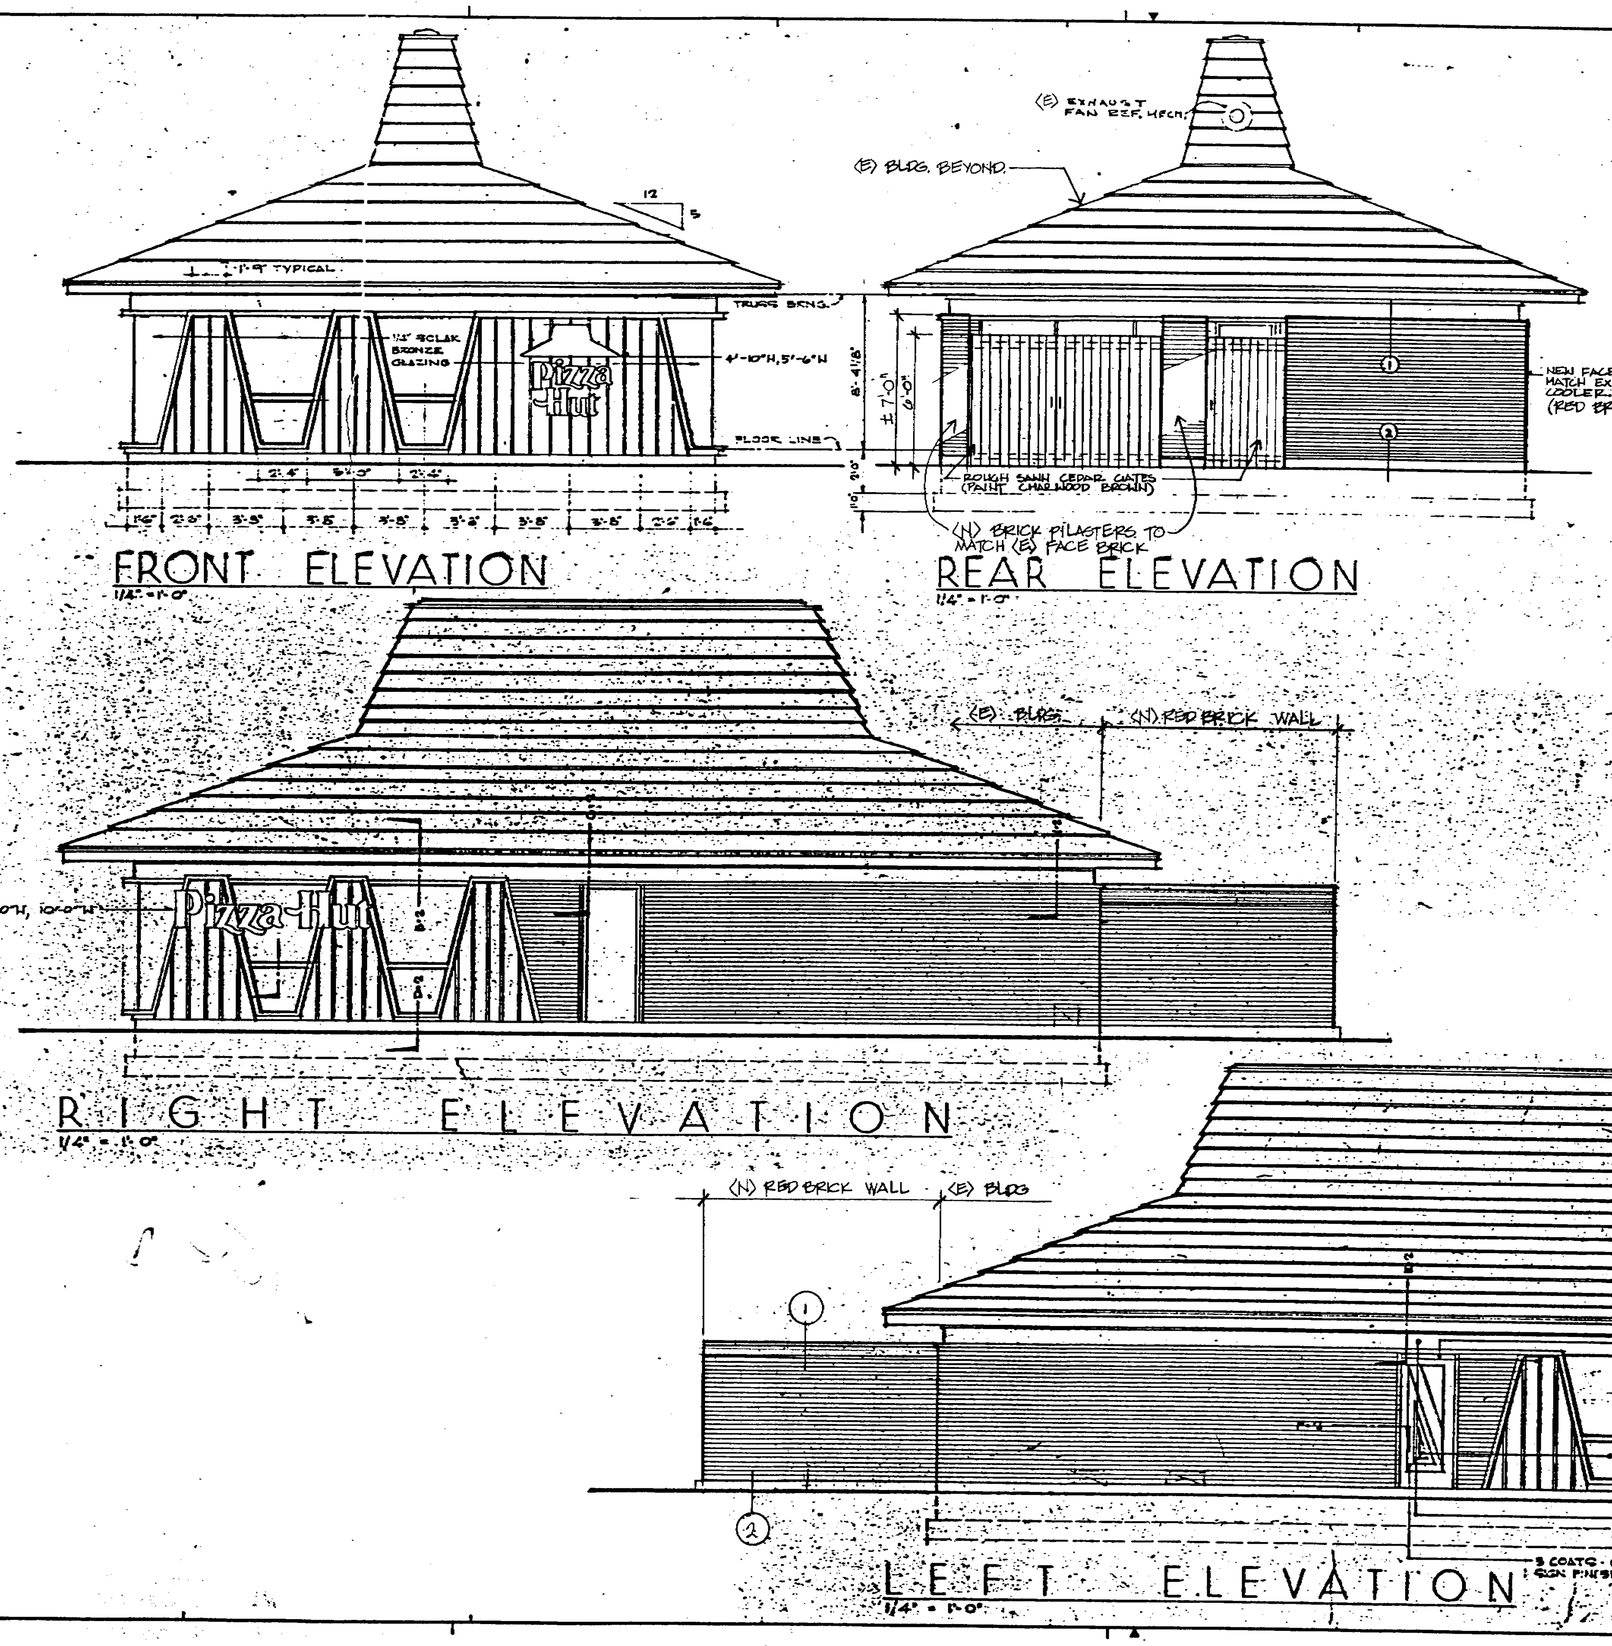

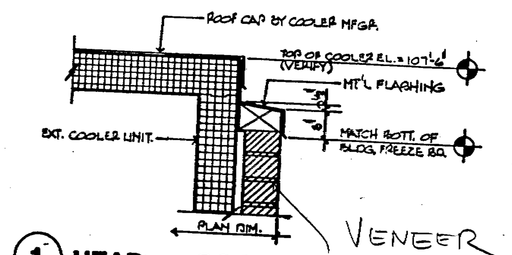

1 HEAD AT COOLER

VENEER SUPPORT AS PER UBC Ch. 30

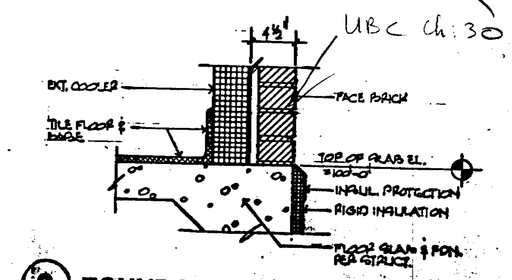

2 FOUNDATION AT COOLER

60981-1660

Pizza Hut

PIZZA HUT, INC.

9111 EAST DOUGLAS
POST OFFICE BOX 428
WICHITA, KANSAS 67201

The design and details disclosed herein are the exclusive property of Pizza Hut, Inc., and shall not be copied or reproduced in whole or in part without its prior written consent.
©1986 PIZZA HUT, INC.

9111 E. DOUGLAS,
BOX 428
WICHITA, KANSAS 67201

NAGLEE AVENUE #103005
SAN JOSE, CALIFORNIA

DATE	BY	CHK'D
4-16-86	MLN	
REVIS'D	BY	CHK'D
6-1-86		